

~~F-16 Det~~
~~F-17~~
 F-21 Mask
 W-22
 WP-34
 WD-35

Clean Vault
 mold on wood
 Base Board.
 40 old books to be
 vacuumed.

Remove 10'
 of wall
 1-370 Asbestos
 studs & All
 go

Remove 30'
 of wall 1-371 ASB
 studs & All
 go.


Demolition Legend	
	Walls, windows, doors, fixtures, etc. are to be removed and scrapped unless noted otherwise (U.N.O.)
	Existing construction, equipment and fixtures to remain.
	(e) Earth fill to remain
	Area of (e) earth fill to be removed
	Area of (e) conc. slab to be removed

Demolition Notes

- For the purpose of Architectural work, all items not shown to be removed or altered on this sheet shall remain in their existing condition. This pertains to all equipment and other consultant's work. See other disciplines for additional demolition and alterations to utilities. Notify the Architect of any components which vary from those shown on the drawings.
- In the event that demolition work creates a condition where existing spaces are open to the weather, the Contractor shall protect the building from the effects of exposure from exterior conditions. These conditions shall be weather-tight at the conclusion of his work each night. At the conclusion of his work in that area the Contractor is to replace all removed components to a weather-tight condition to match adjacent finishes.
- See Selective Demolition, Cutting and Patching sections in Project Manual for additional demolition requirements.
- Protect adjacent surfaces to remain from damage. Contractor is to repair or replace all finishes that are damaged or removed due to the installation or removal of any materials, fixtures, accessories or construction noted on these drawings. Repaired or replaced finishes shall match adjacent existing surfaces.
- Refer to Ceiling Demolition Plan for extent of ceiling demolition.
- Dimensions must be field verified prior to the start of work.
- Revise mechanical and fire sprinkler systems as required. Contractor to field verify extent of work required.
- Hazardous Materials: It is unknown whether hazardous materials will be encountered in the Work.
- Wood Window Trim: Contractor shall remove and salvage all existing wood trim on face of wall at existing windows, where occurs, U.N.O. Existing wood trim within window openings (head, jamb, sill) shall remain in place. Contractor shall be responsible for repairing/patching and or replacing any damaged or lost wood trim.
- Wood Base Trim: Contractor shall remove and salvage all existing wood base trim at walls where concrete shear reinforcement and furring is to be installed and/or where floor decking and framing is to be removed and replaced. Contractor shall be responsible for repairing/patching and or replacing any damaged or lost wood trim.
- Definitions:
 Remove: Detach items from existing construction and legally dispose of them off-site, unless indicated to be removed and salvaged or removed and reinstalled.
 Remove and salvage: Detach items from existing construction and deliver them to the Owner.
 Remove and reinstall: Detach items from existing construction, prepare them for reuse, and reinstall them where indicated.
 Existing to remain: Existing items of construction that are not to be removed and that are not otherwise indicated to be removed, removed and salvaged, or removed and reinstalled.

note

17-008

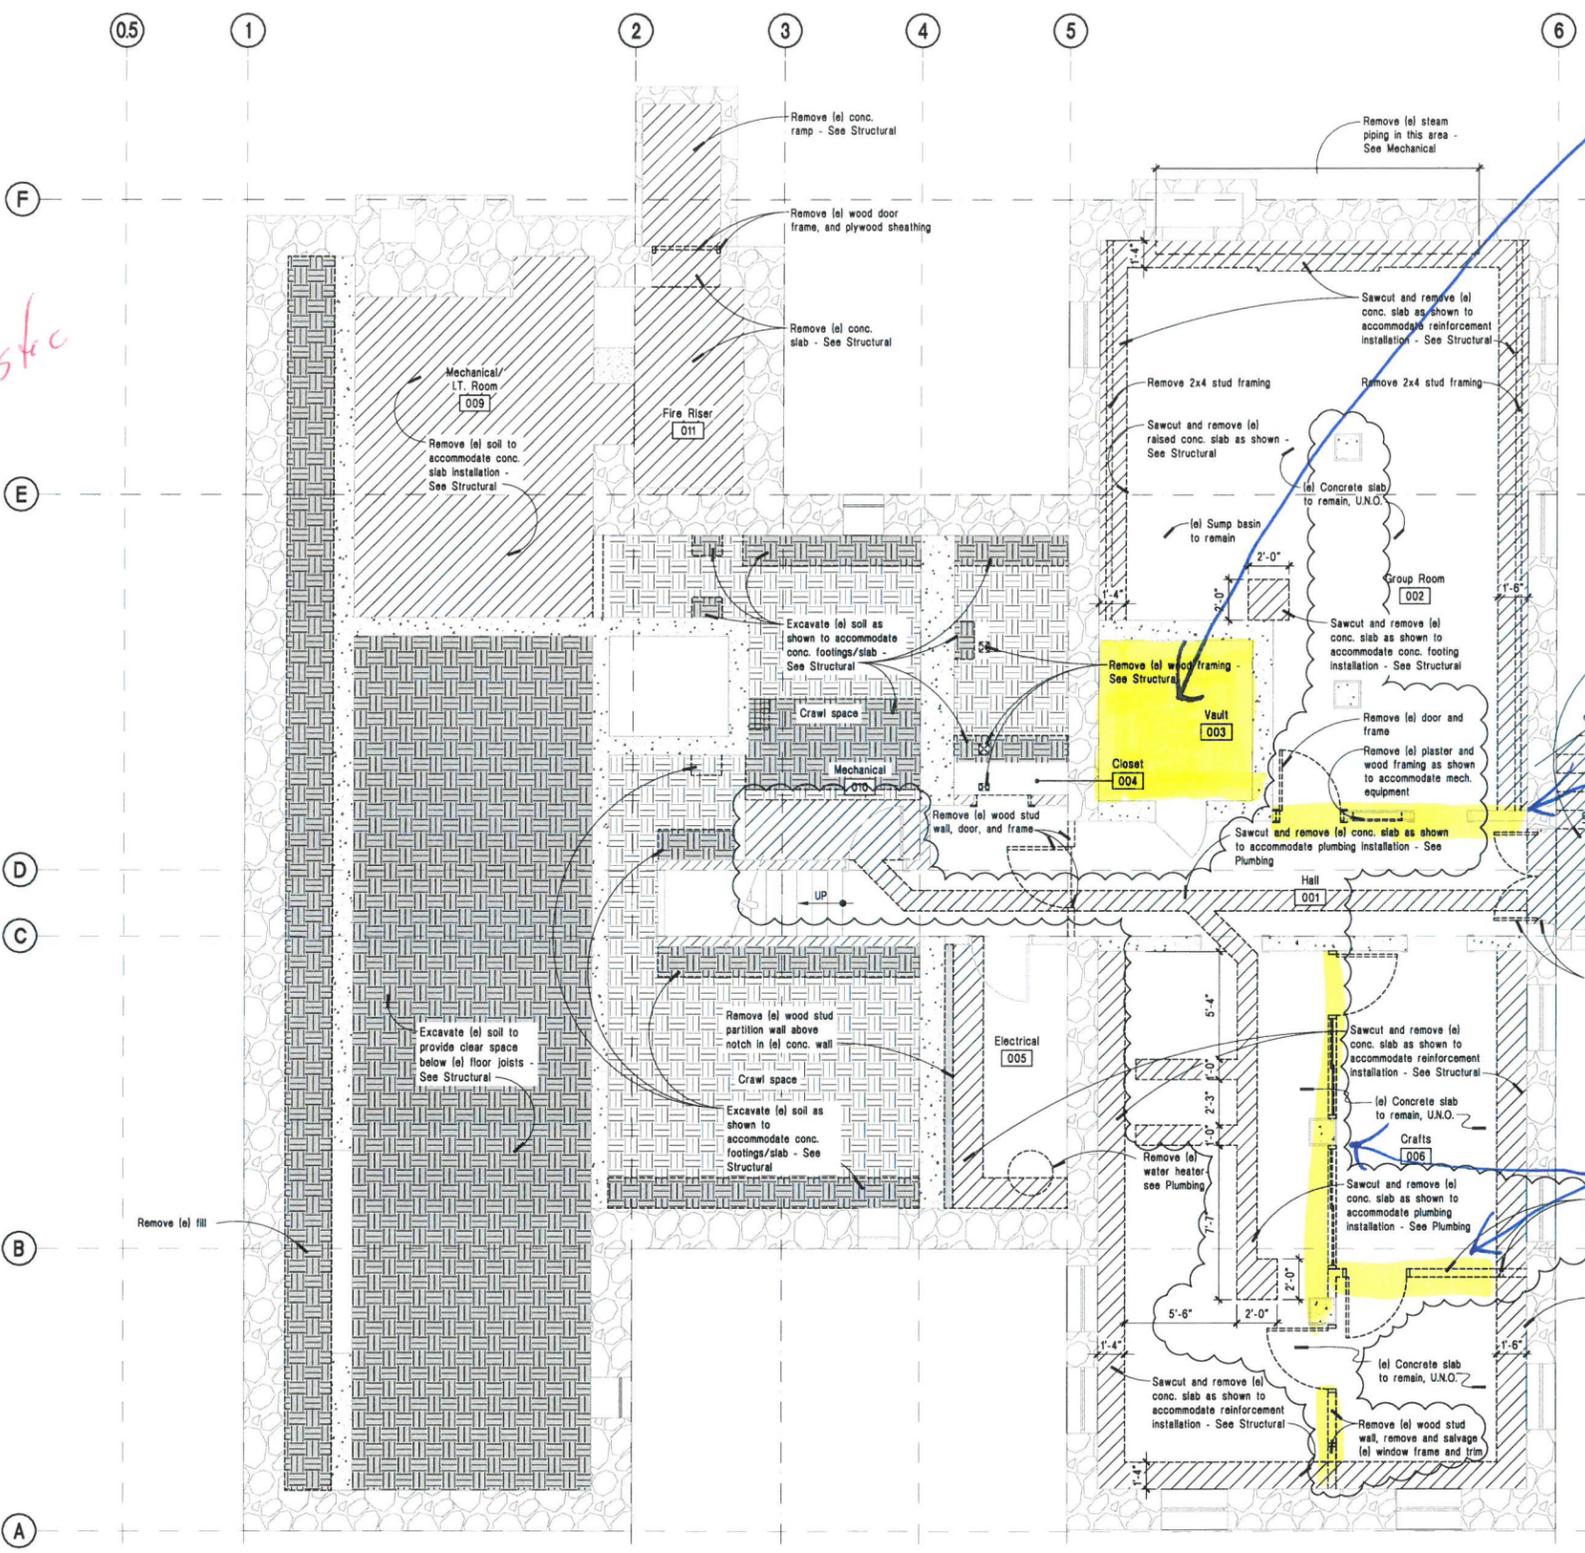

1 Overall Basement Demolition Plan
 1/4" = 1'-0"

S13 011109 February 20, 2018 5:00 PM

PRELIMINARY
 Not For Construction

Professional Seal	Date	Revision



H+K ARCHITECTS
 5485 Reno Corporate Drive, Suite 100
 Reno, Nevada 89511-2262
 P 775+332+6640
 F 775+332+6642
 hkarchitects.com

Stewart Indian School
Volume III Cultural Center
 State of Nevada Indian Commission
 5366 Snyder Avenue, Building 1
 Carson City, NV 89701

Basement Demolition Plan
 January 26, 2018
 H+K Project No.: 1720 & 1721
D111



250 39
2nd Floor
Mastic on
Wood
Scrap off.

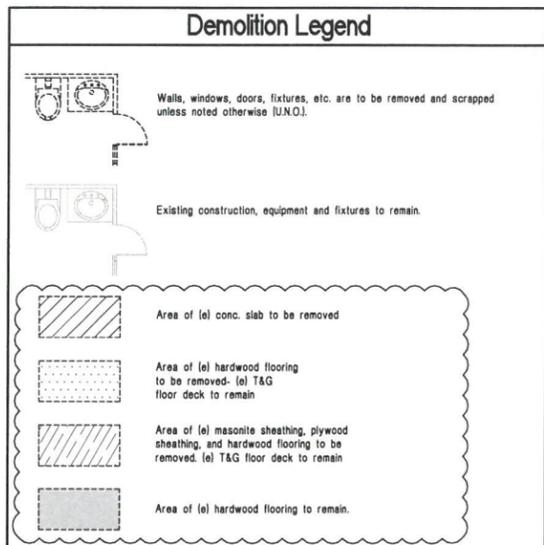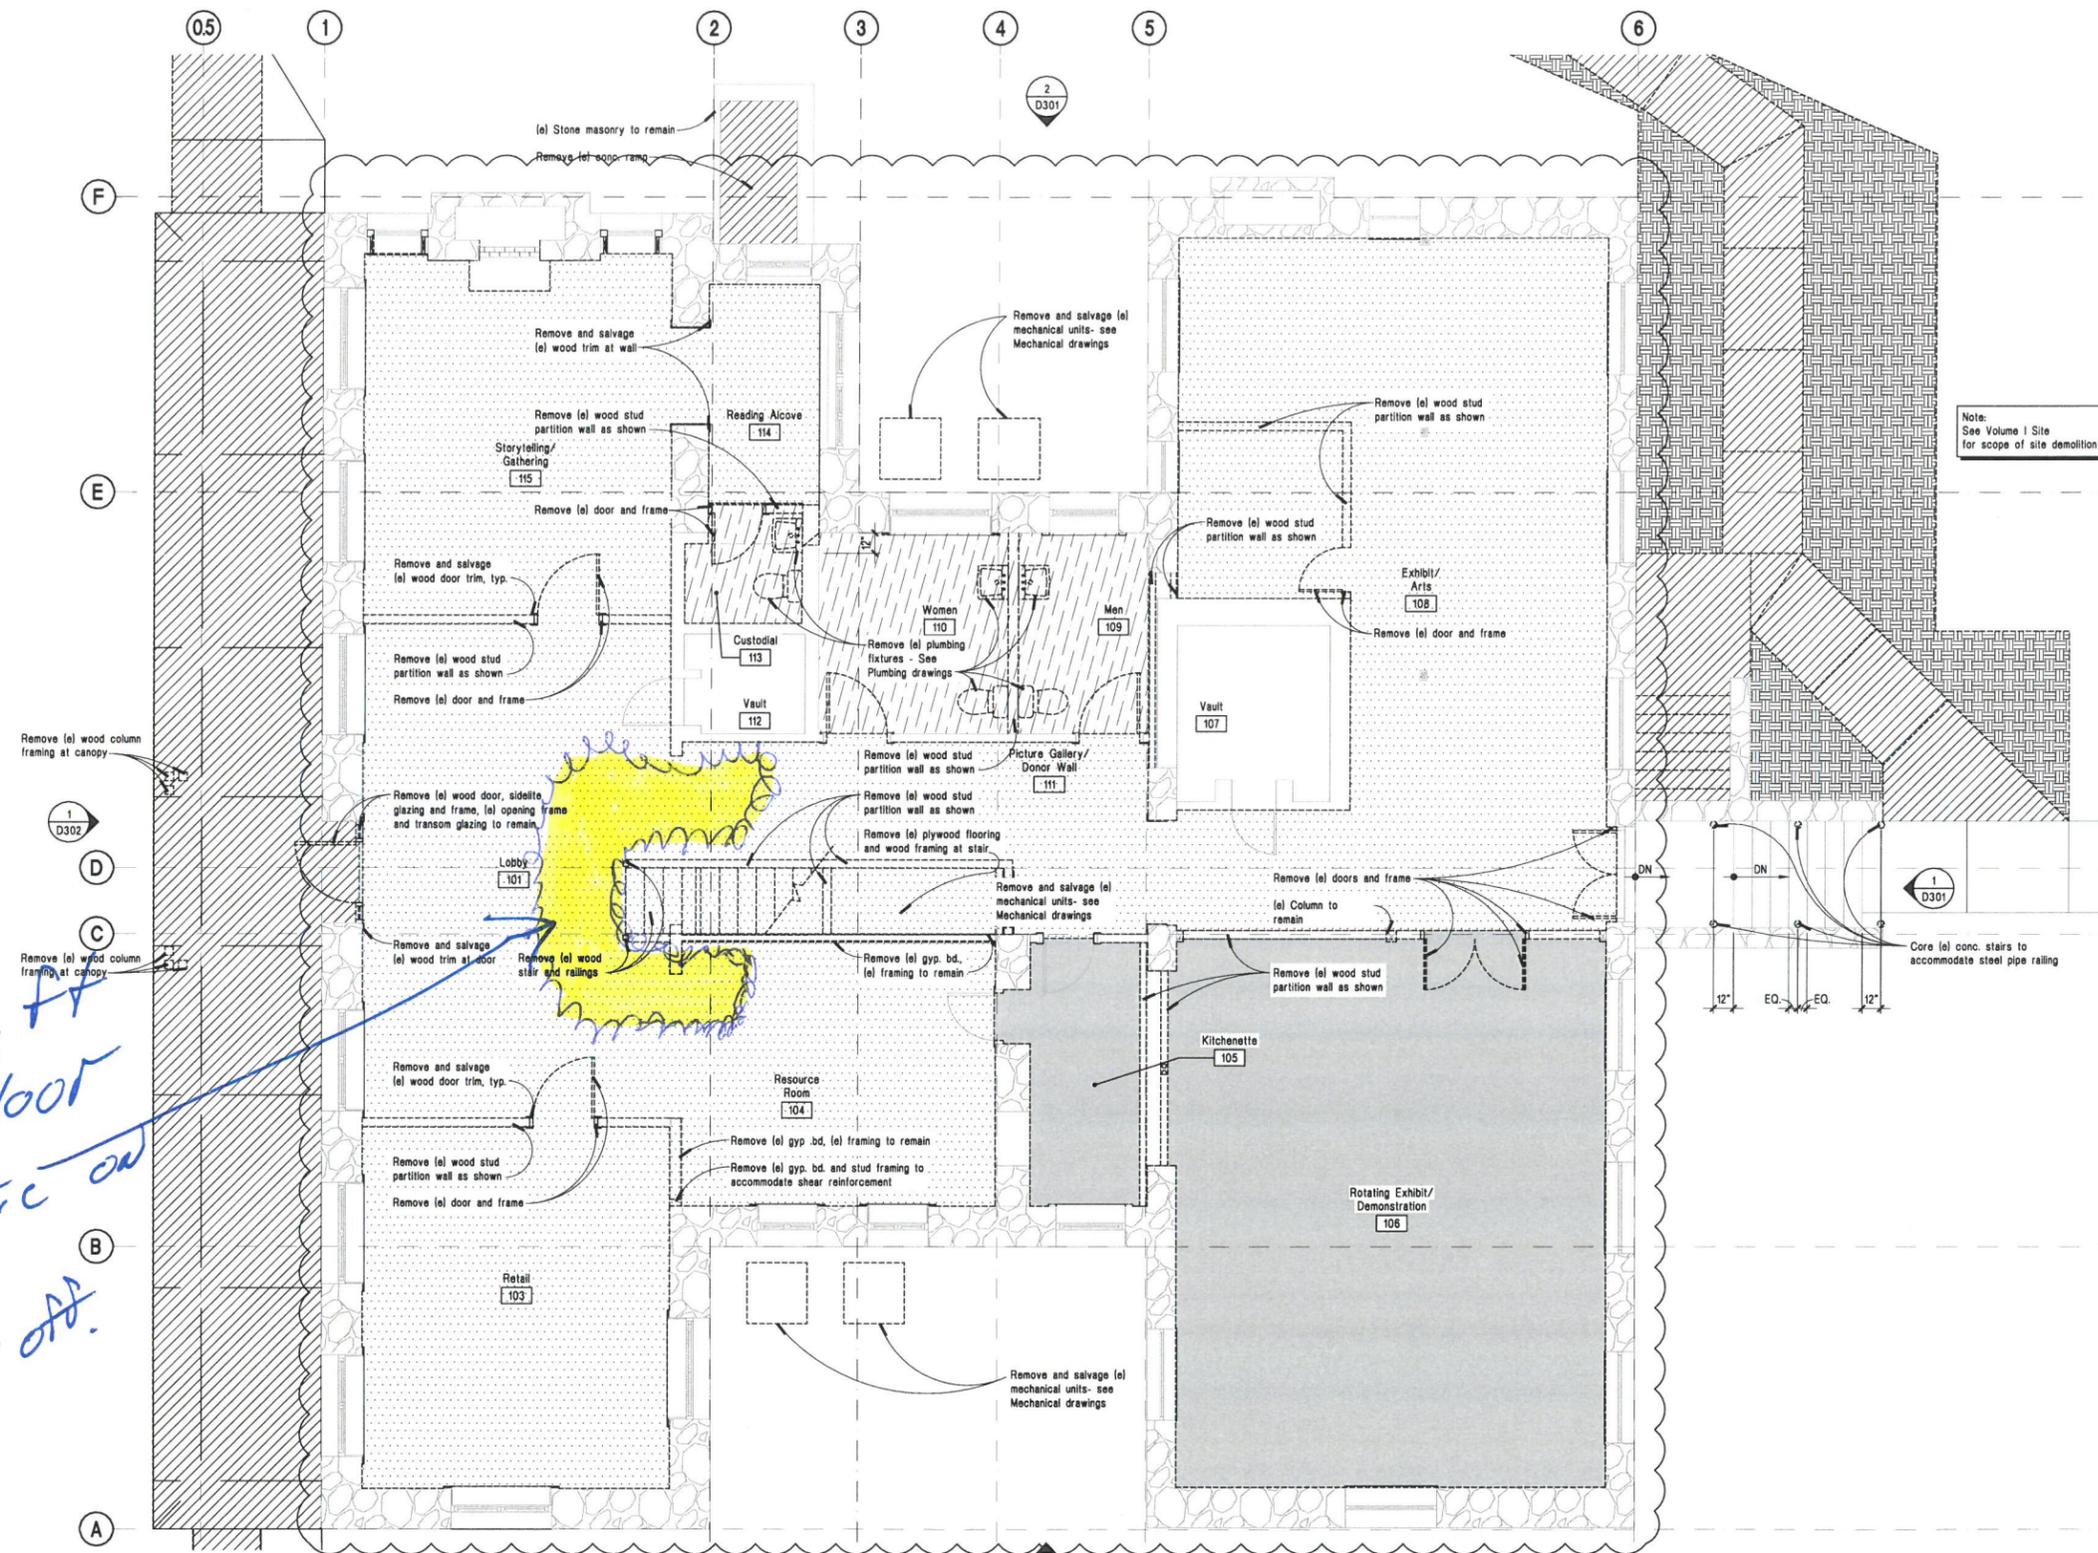

- ### Demolition Notes
- For the purpose of Architectural work, all items not shown to be removed or altered on this sheet shall remain in their existing condition. This pertains to all equipment and other consultant's work. See other disciplines for additional demolition and alterations to utilities. Notify the Architect of any components which vary from those shown on the drawings.
 - In the event that demolition work creates a condition where existing spaces are open to the weather, the Contractor shall protect the building from the effects of exposure from exterior conditions. These conditions shall be weather-tight at the conclusion of his work each night. At the conclusion of his work in that area the Contractor is to replace all removed components to a weather-tight condition to match adjacent finishes.
 - See Selective Demolition, Cutting and Patching sections in Project Manual for additional demolition requirements.
 - Protect adjacent surfaces to remain from damage. Contractor is to repair or replace all finishes that are damaged or removed due to the installation or removal of any materials, fixtures, accessories or construction noted on these drawings. Repaired or replaced finishes shall match adjacent existing surfaces.
 - Refer to Ceiling Demolition Plan for extent of ceiling demolition.
 - Dimensions must be field verified prior to the start of work.
 - Revise mechanical and fire sprinkler systems as required. Contractor to field verify extent of work required.
 - Hazardous Materials: It is unknown whether hazardous materials will be encountered in the Work.
 - Wood Window Trim: Contractor shall remove and salvage all existing wood trim on face of wall at existing windows, where occurs, U.N.O. Existing wood trim within window openings (head, jams, sill) shall remain in place. Contractor shall be responsible for repairing/patching and or replacing any damaged or lost wood trim.
 - Wood Base Trim: Contractor shall remove and salvage all existing wood base trim at walls where concrete shear reinforcement and furring is to be installed and/or where floor decking and framing is to be removed and replaced. Contractor shall be responsible for repairing/patching and or replacing any damaged or lost wood trim.
 - Definitions:
 Remove: Detach items from existing construction and legally dispose of them off-site, unless indicated to be removed and salvaged or removed and reinstalled.
 Remove and salvage: Detach items from existing construction and deliver them to the Owner.
 Remove and reinstall: Detach items from existing construction, prepare them for reuse, and reinstall them where indicated.
 Existing to remain: Existing items of construction that are not to be removed and that are not otherwise indicated to be removed, removed and salvaged, or removed and reinstalled.

1 Overall First Floor Demolition Plan
 1/4" = 1'-0"
 North