NEVADA
STATE HISTORIC PRESERVATION OFFICE

Department of Conservation and Natural Resources

Steve Sisolak, Governor
Bradley Crowell, Director
Rebecca L. Palmer, Administrator, SHPO

Stewart Facility
5500 Snyder Avenue, Carson City, NV 89701

Request for Permission to Undertake Structural or Visual Alterations

In accord with the requirements set forth in existing covenants,
Buildings & Grounds (*name of agency*) is requesting written permission to undertake visual or structural alterations as described below:

Building Number and Name: #89, Dept. of Corrections

Building's Date of Construction: 1931

Supplementary Information:
Please indicate if you have submitted the following–

- [x] Written description of proposed work (***required; see second page***)
- [x] Photographs of existing conditions (***required***)
- [x] Sketches, plans, or architectural drawings depicting the proposed work
- [ ] Sketch or site plan of project location
- [ ] Specs of materials to be used
- [ ] Historic photographs depicting past condition or design
- [ ] Other

Request Submitted by:

RONALD BODNAR

Print name *Signature*

Agency – Buildings & Grounds
Title – Facility Supervisor II
Email address – rbodnar@admin.nv.gov
Phone number – (775) 690-8787

Date of Request: 1/14/21
Please allow up to 14 business days for this form to be processed. Proposed work must not begin until this form has been reviewed and approved by both the State Historic Preservation Office and the Nevada Indian Commission. In some cases, coordination with State Lands is also necessary. Per NRS 321.003, a state agency must also submit a Certification Request to the Nevada Division of State Lands before constructing a building or making other permanent improvements to state lands. This includes ground disturbance for site work and utilities. If your project requires a State

Lands Certification, you will find the instructions on the Division of State Lands website under "Forms."
http://www.lands.nv.gov/

To expedite your project, the SHPO recommends coordinating with SHPO and State Lands concurrently.

Please submit request form and supplementary materials to the State Historic Preservation Office, 901 S. Stewart St., Ste. 5004, Carson City, NV 89701-5248 or by email to rlpalmer@shpo.nv.gov.

REQUEST APPROVED BY:

SHPO - Kristen Brown 2-2-21
Print and sign name *Date*

Nevada Indian Commission - Sari Nichols 2/2/21
Print and sign name *Date*

* **Nevada Division of State Lands -** _____
Print and sign name *Date*

* (If required)

Description of Proposed Work:
Please provide a thorough written description of the proposed work, including–

- Location on building
- Approximate size of area affected
- Existing conditions
- Materials to be used
- Proposed methods (must follow the *Secretary of the Interior's Standards*)

(Use as many pages as needed)

Ronald Bodnar

Subject: FW: Bldg #89

Hello Rebecca, we would like to put an interior door in building 89, as you can see by the plans the work area shows that there was a door there at one time, but it got taken out and covered with sheet rock, it's a little difficult to see in the pictures but the one showing a light switch in the middle of the wall tells me that that was for when you walked in the door to the office. We will put an as like door and frame back in. Please let me know if we can move forward with this project, thanks.

Ron Bodnar
Stewart Facility Supervisor II
State Public Works Division
Buildings & Grounds Section
Phone (775) 687-3021
Cell (775) 690-8787
email rbodnar@admin.nv.gov

SHEET NOTES

1. AT EACH OF 4 - (E) ATTIC AIR HANDLERS, PROVIDE NEW 500 VA BUCK - BOOST TRANSFORMERS: 208 → 240 V., 1Φ, 2W. VERIFY LOCATIONS.

ADD. ALT. #2

3" C. W/ 4-300 MCM AL & 1#4 GC TO BLDG. #10 - SEE 1/E-1

SAW - CUT & REPAIR (E) CONCRETE SIDEWALK

HAND DIG THIS AREA TO AVOID EXISTING UTILITIES

REMOVE (E) 50 KVA 1Φ SERVICE TRANSFORMER.

NEW 225 KVA 3Φ SERVICE TRANSFORMER.

NEW CONCRETE EQUIPMENT PAD W/ PERIMETER FOOTING. (NEW FREE GROUND)

INTERCEPT & RECONNECT (E) 1.G. SECONDARY FEEDER (3 - 1/0 & 2 AL)

TO (E) AUDITORIUM #30

REMOVE (E) SERVICE GUTTER.

NEW SERVICE SWITCHBOARD 'MSB' & PANEL 'G'

ADD. ALT. #2

NEW PANEL 'D' (CUT INTO (E) WALL)

(E) COURTYARD

ADDITIVE ALTERNATE #1

20 A. 208 V. 1Φ 2W. 1-GROUND RECEPTACLE (NEMA 6-20) IN ALUMINUM FLOOR PEDESTAL (TYPICAL OF 6)

CONCEAL ALL CIRCUITING IN ACCESSIBLE CRAWL SPACE (TYPICAL)

(E) PANEL 'A'

(E) PANEL 'B'

20 A. 120 V. 1Φ, 2W. 1-GROUND RECEPTACLE (NEMA 5-20) IN ALUMINUM FLOOR PEDESTAL. (TYPICAL OF 44)

(E) COURTYARD

WORK AREA

NEW PANEL 'E' (CUT INTO (E) WALL)

ADD. ALT. #2

ADD. ALT. #2

AS BUILT 11 AUGUST 09

BUILDING 89: ELECTRICAL PLAN

A E-2

NEA ENGINEERING, INC.
12000 W. Charleston Blvd., Suite #6
Las Vegas, Nevada 89066
(702) 256-8999

DR.	KD
CK.	MD
DATE	DECEMBER 5 1988

NEVADA
STATE PUBLIC WORKS BOARD
CARSON CITY

REMODEL BUILDING 89, STEWART FACILITY
ELECTRICAL SERVICE

BUILDING 89 ELECTRICAL PLAN

AUG 18

SHEET NO.	
E-2	4

DWG. NO. 89-121(5) E-2

35-1 U-112

OLD
DOOR

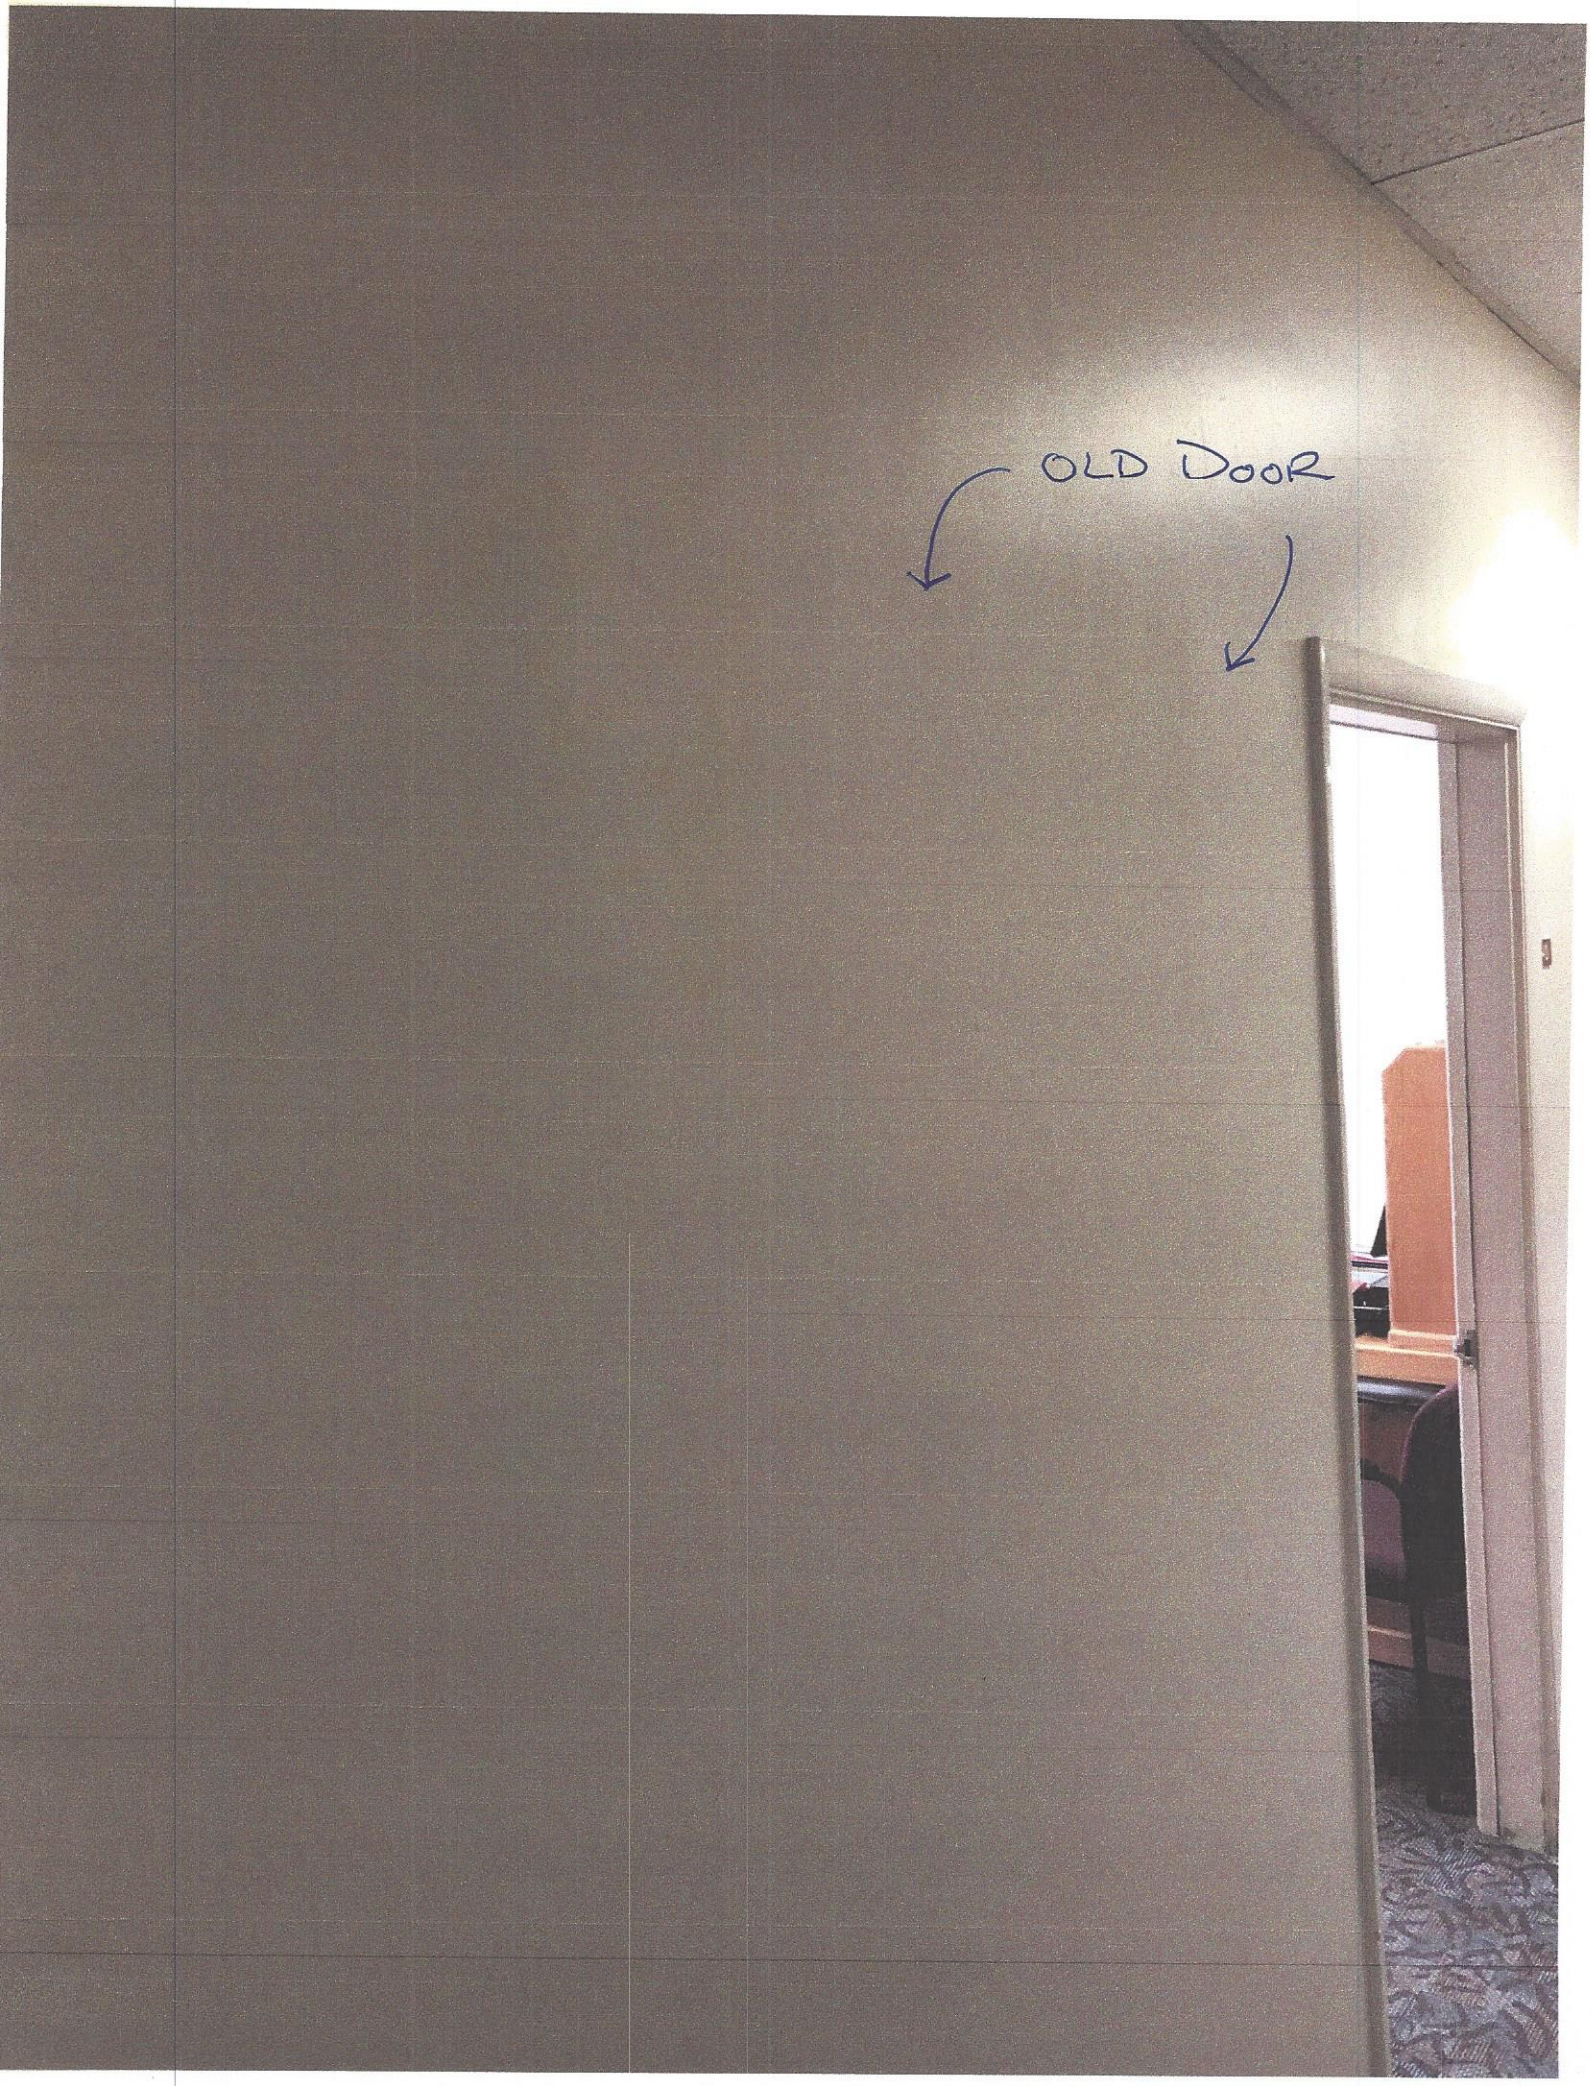
OLD DOOR